
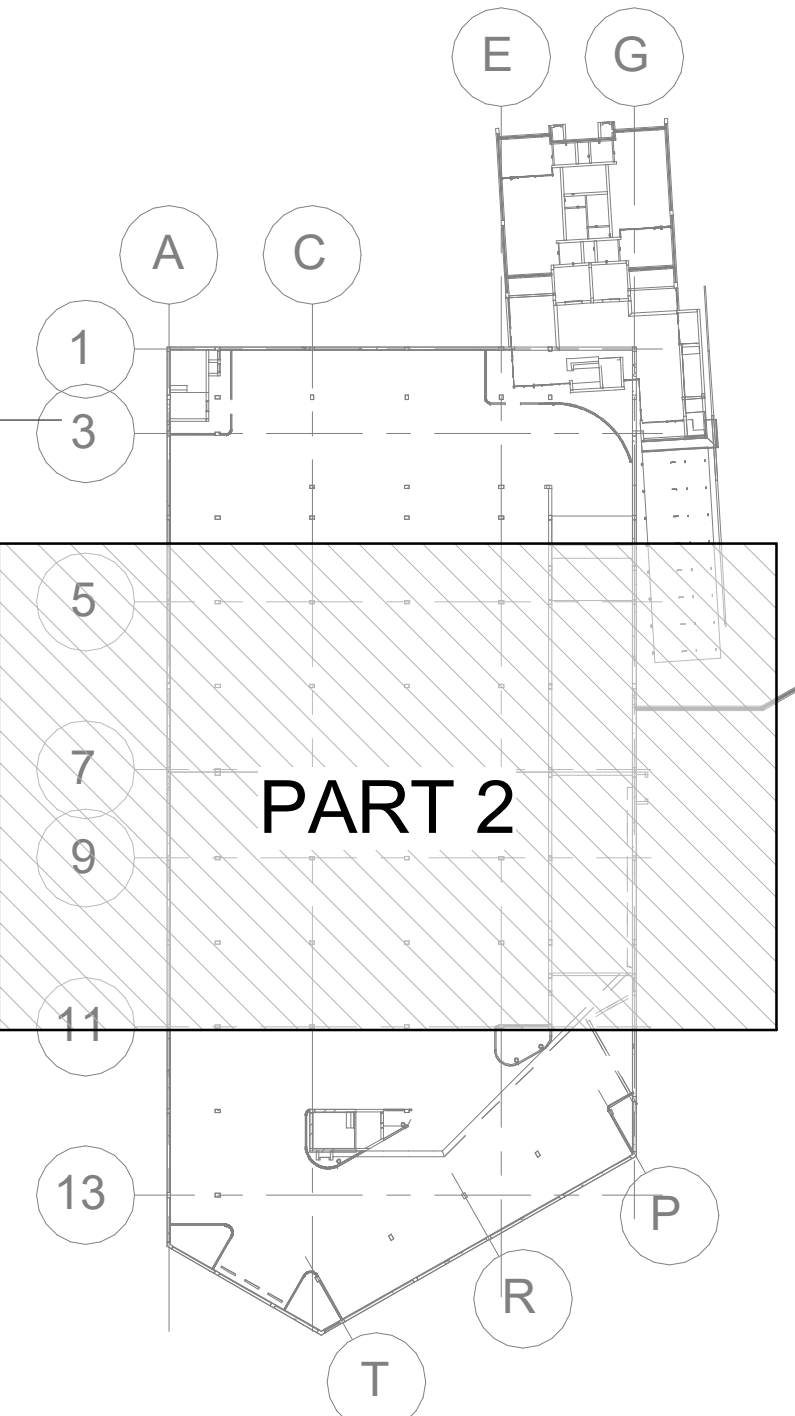


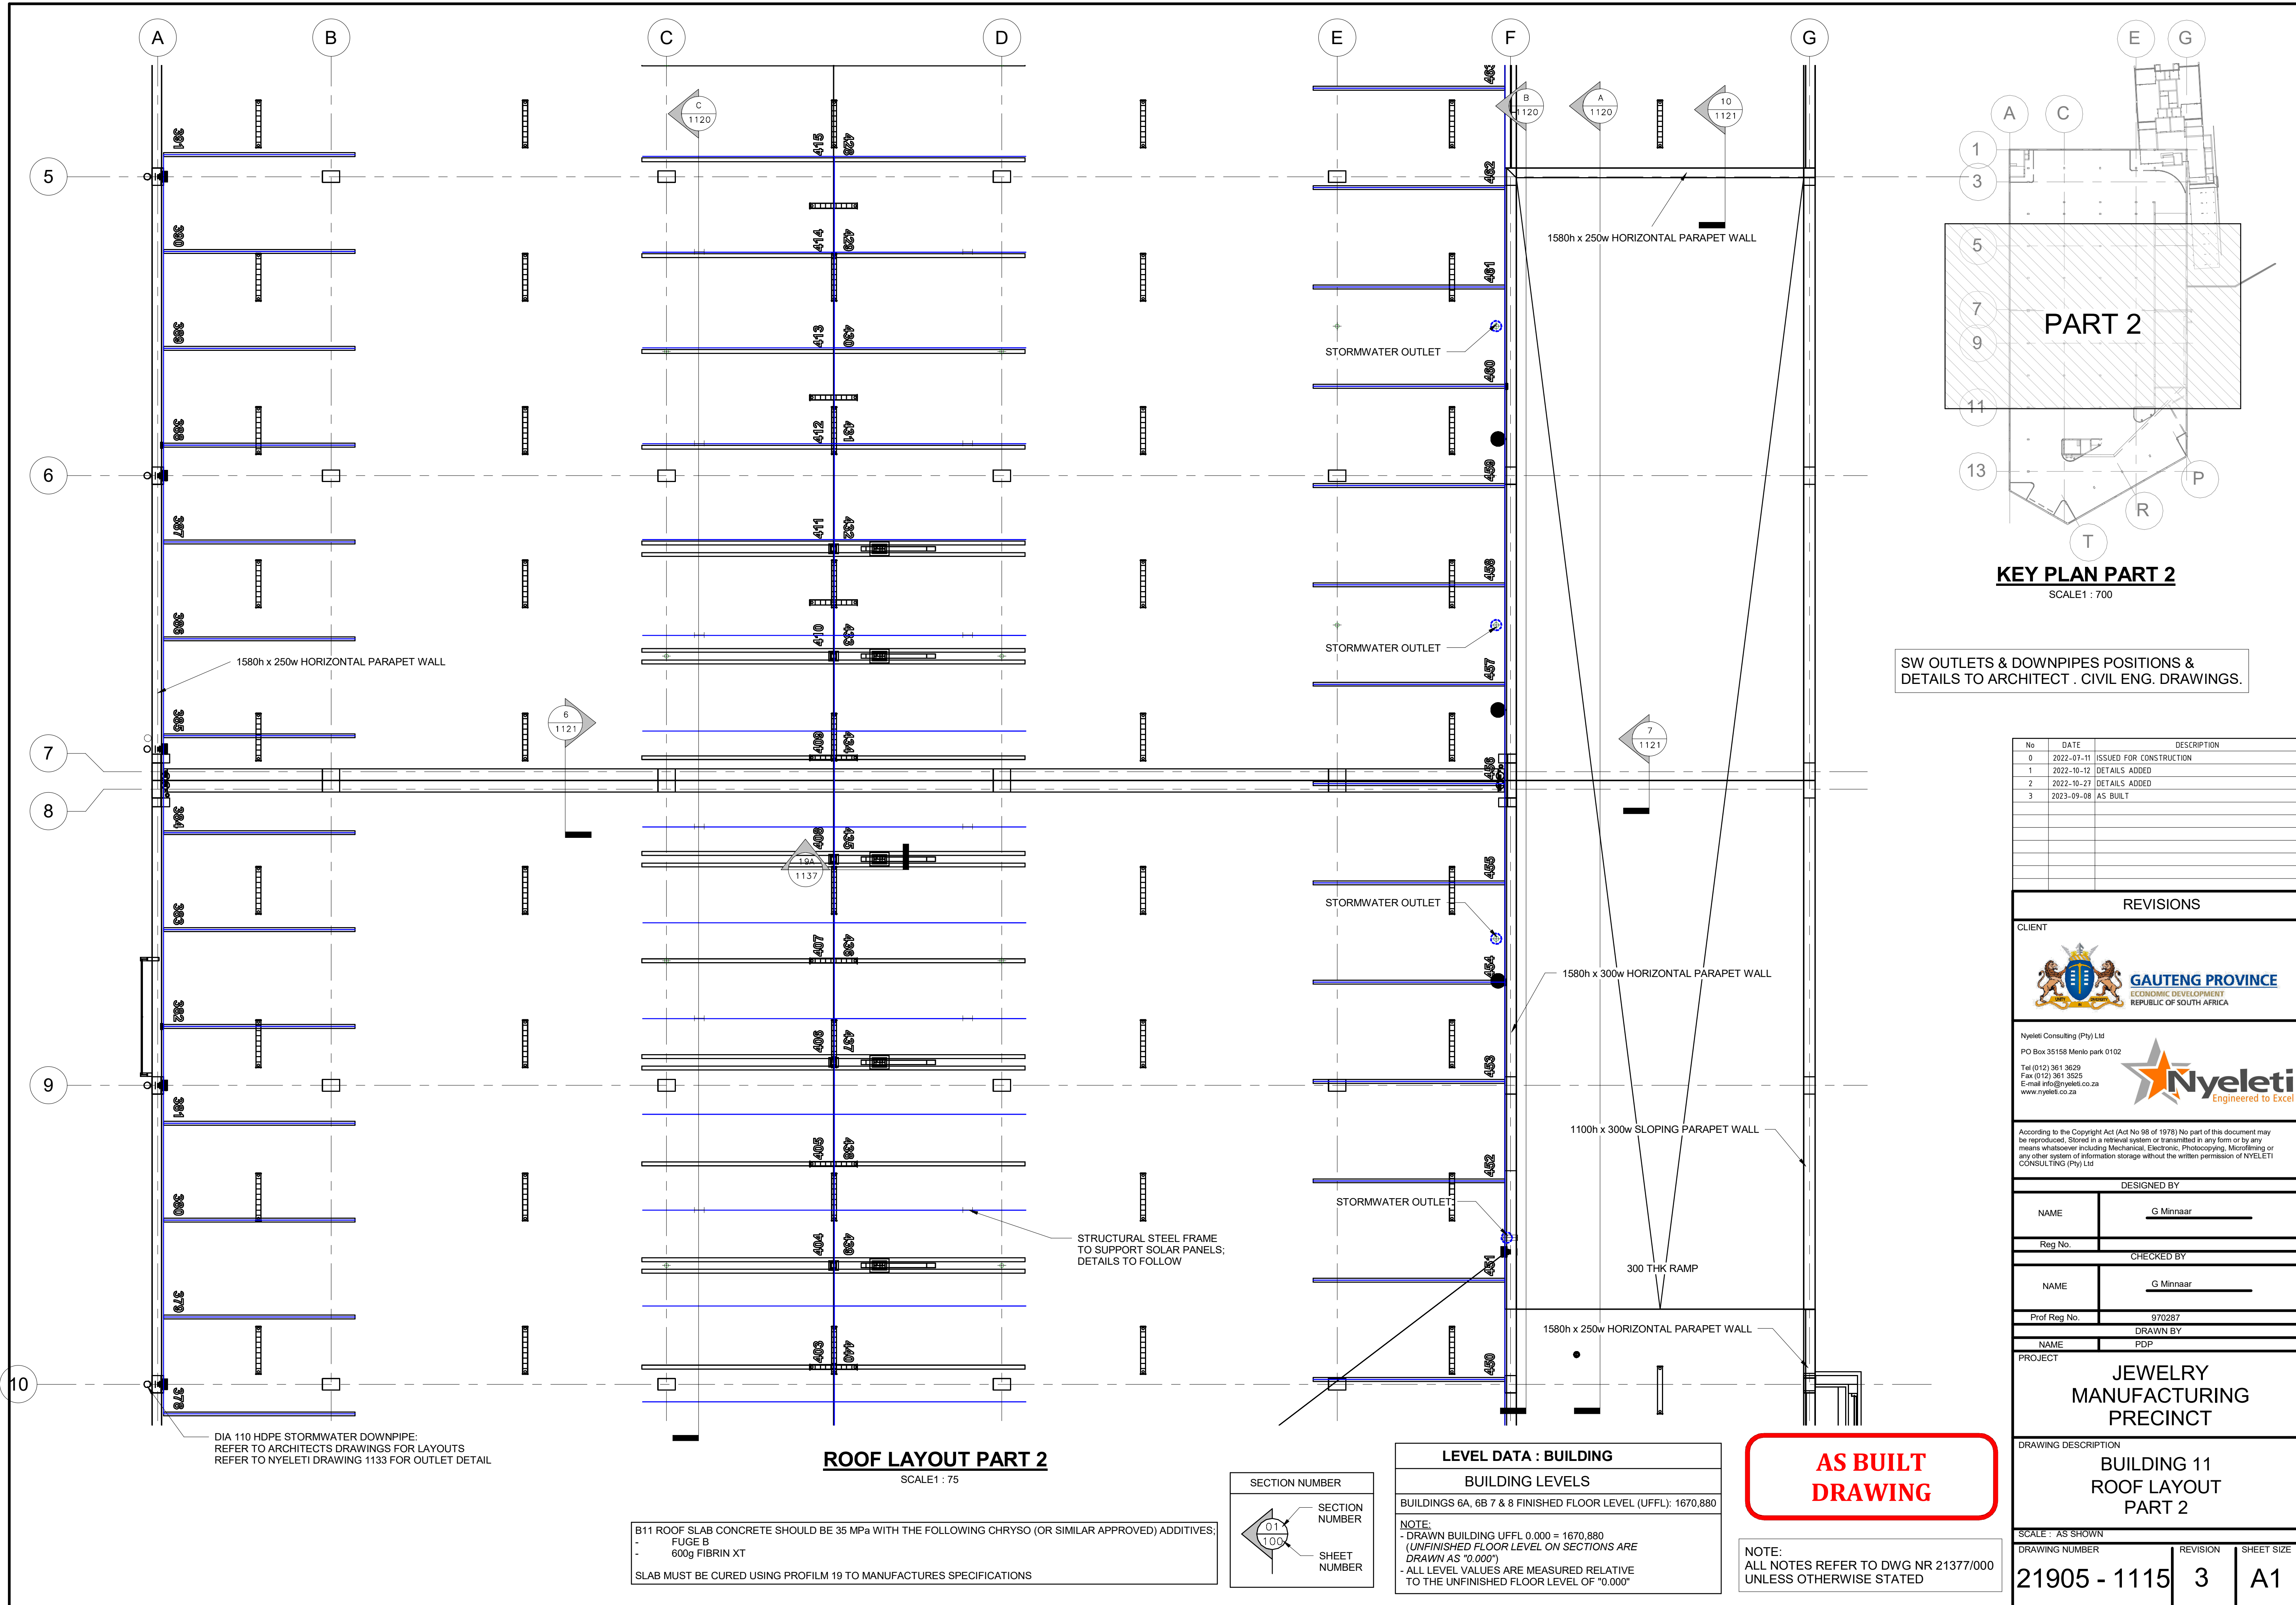

KEY PLAN PART 2
SCALE 1 : 700

SW OUTLETS & DOWNPIPES POSITIONS & DETAILS TO ARCHITECT . CIVIL ENG. DRAWINGS.

No	DATE	DESCRIPTION
0	2022-07-11	ISSUED FOR CONSTRUCTION
1	2022-10-12	DETAILS ADDED
2	2022-10-27	DETAILS ADDED
3	2023-09-08	AS BUILT

REVISIONS		
CLIENT		
 GAUTENG PROVINCE ECONOMIC DEVELOPMENT REPUBLIC OF SOUTH AFRICA		
Nyeleti Consulting (Pty) Ltd PO Box 35158 Menlo park 0102 Tel (012) 361 3629 Fax (012) 361 3525 E-mail info@nyeleti.co.za www.nyeleti.co.za  Nyeleti Engineered to Excel		
According to the Copyright Act (Act No 98 of 1978) No part of this document may be reproduced, stored in a retrieval system or transmitted in any form or by any means whatsoever including Mechanical, Electronic, Photocopying, Microfilming or any other system of information storage without the written permission of NYELETI CONSULTING (Pty) Ltd		
DESIGNED BY		
NAME	G Minnaar	
Reg No.		
CHECKED BY		
NAME	G Minnaar	
Prof Reg No.	970287	
DRAWN BY		
NAME	PDP	
PROJECT		
JEWELRY MANUFACTURING PRECINCT		
DRAWING DESCRIPTION		
BUILDING 11 ROOF LAYOUT PART 2		
SCALE : AS SHOWN		
DRAWING NUMBER	REVISION	SHEET SIZE
21905 - 1115	3	A1

**AS BUILT
DRAWING**

NOTE:
ALL NOTES REFER TO DWG NR 21377/000
UNLESS OTHERWISE STATED

LEVEL DATA : BUILDING	
BUILDING LEVELS	
BUILDINGS 6A, 6B 7 & 8 FINISHED FLOOR LEVEL (UFFL): 1670,880	
NOTE: - DRAWN BUILDING UFFL 0.000 = 1670,880 (UNFINISHED FLOOR LEVEL ON SECTIONS ARE DRAWN AS "0.000") - ALL LEVEL VALUES ARE MEASURED RELATIVE TO THE UNFINISHED FLOOR LEVEL OF "0.000"	

SECTION NUMBER
SECTION NUMBER
SHEET NUMBER

B11 ROOF SLAB CONCRETE SHOULD BE 35 MPa WITH THE FOLLOWING CHRYSO (OR SIMILAR APPROVED) ADDITIVES;
- FUGE B
- 600g FIBRIN XT
SLAB MUST BE CURED USING PROFILM 19 TO MANUFACTURES SPECIFICATIONS