



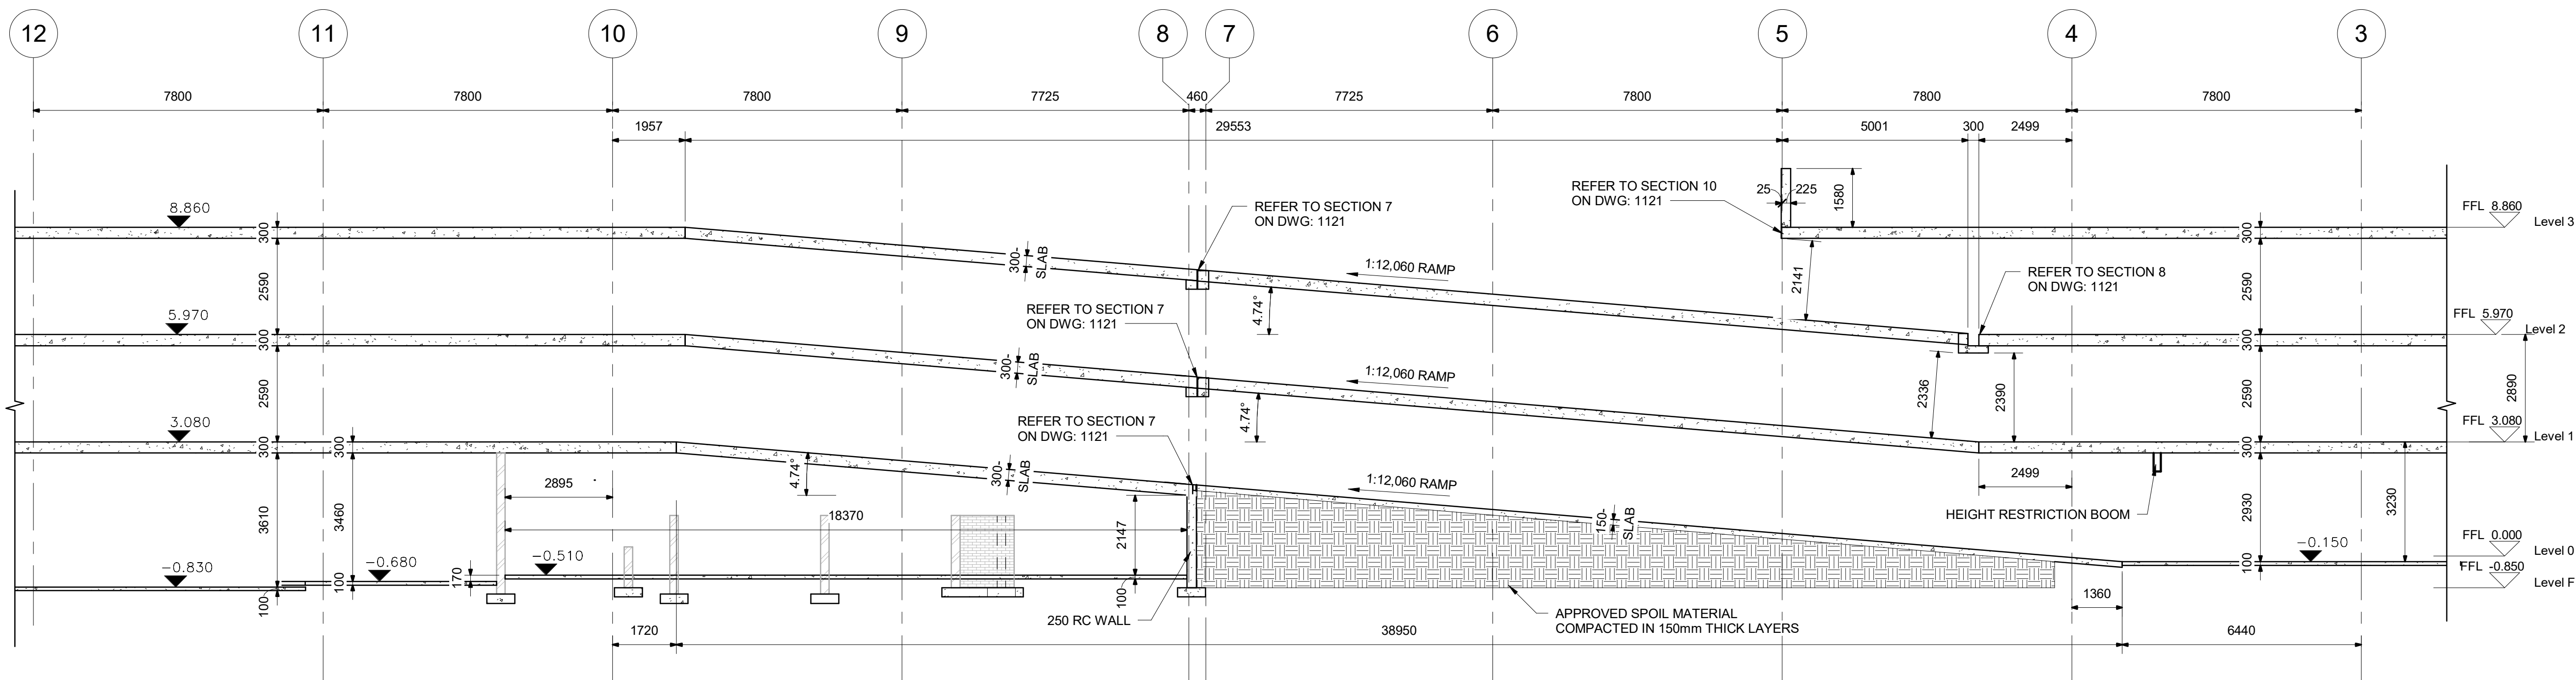

SECTION A RAMP DETAILS


SCALE 1 : 100

SW OUTLETS & DOWNPIPES POSITIONS & DETAILS TO ARCHITECT . CIVIL ENG. DRAWINGS.

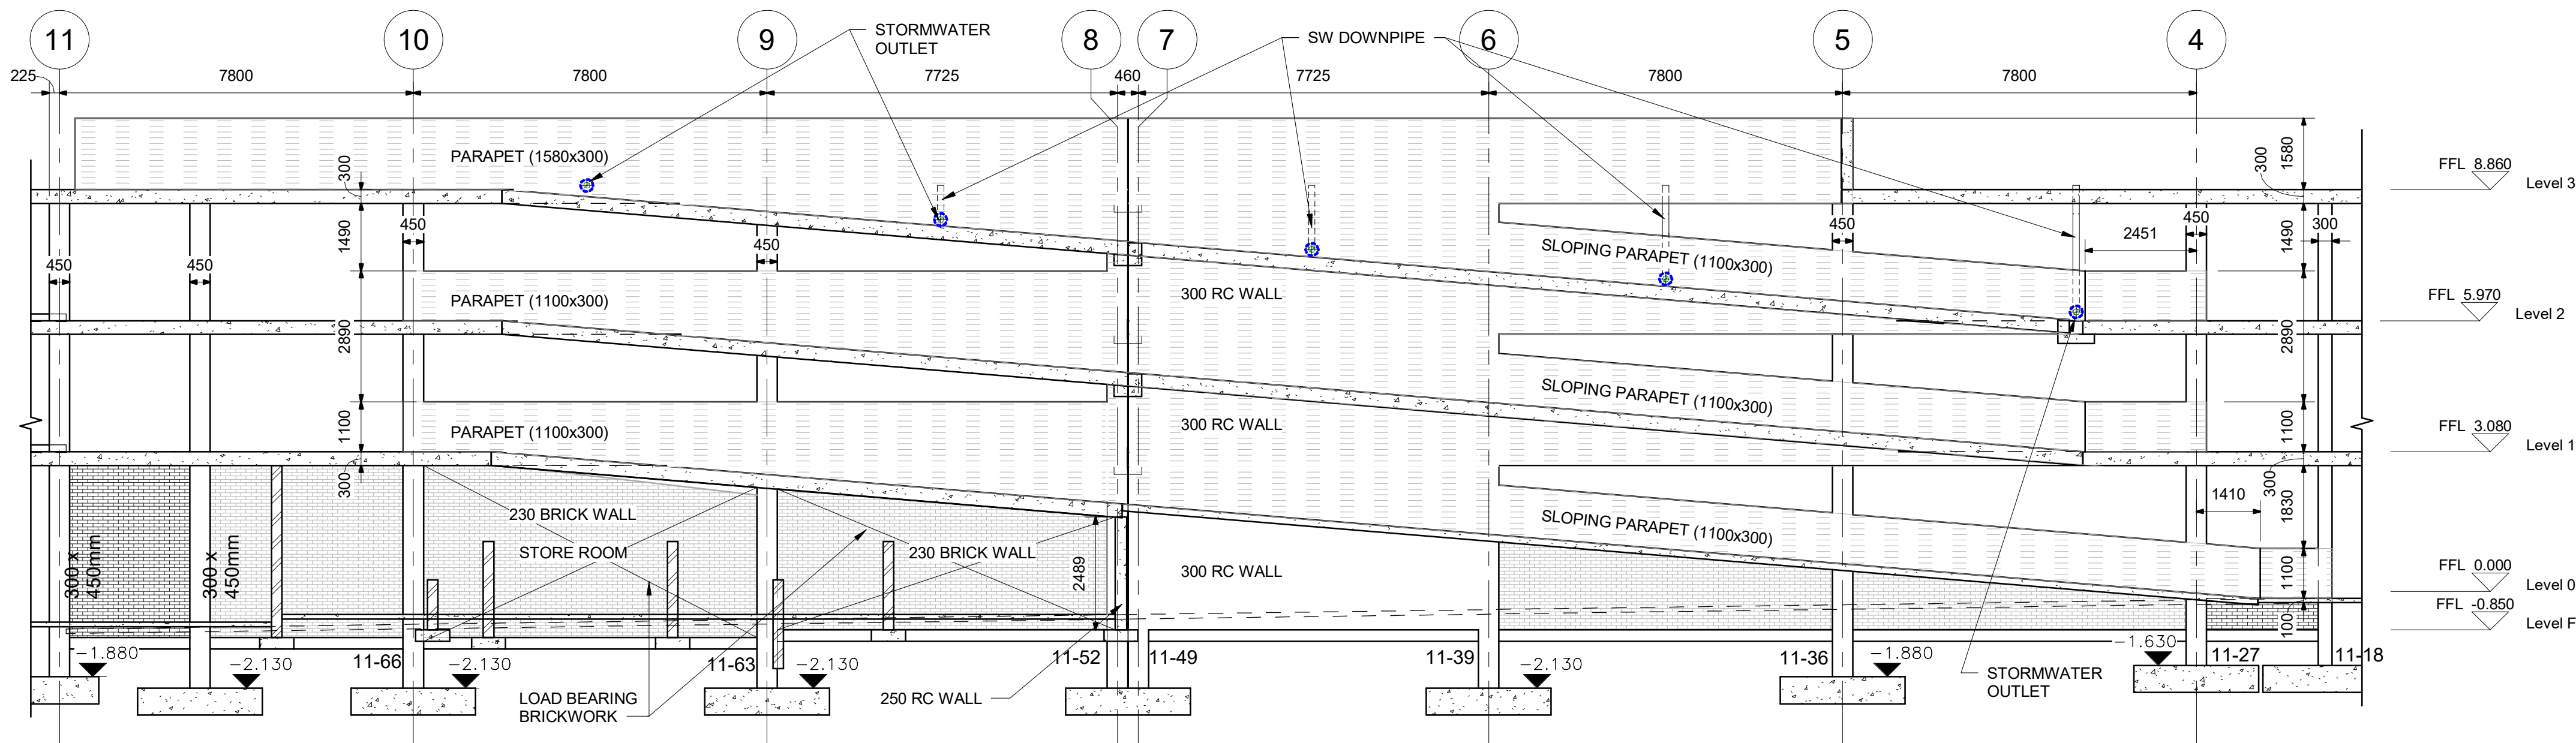

SECTION B GRIDLINE F INNER WALL

SCALE 1 : 100

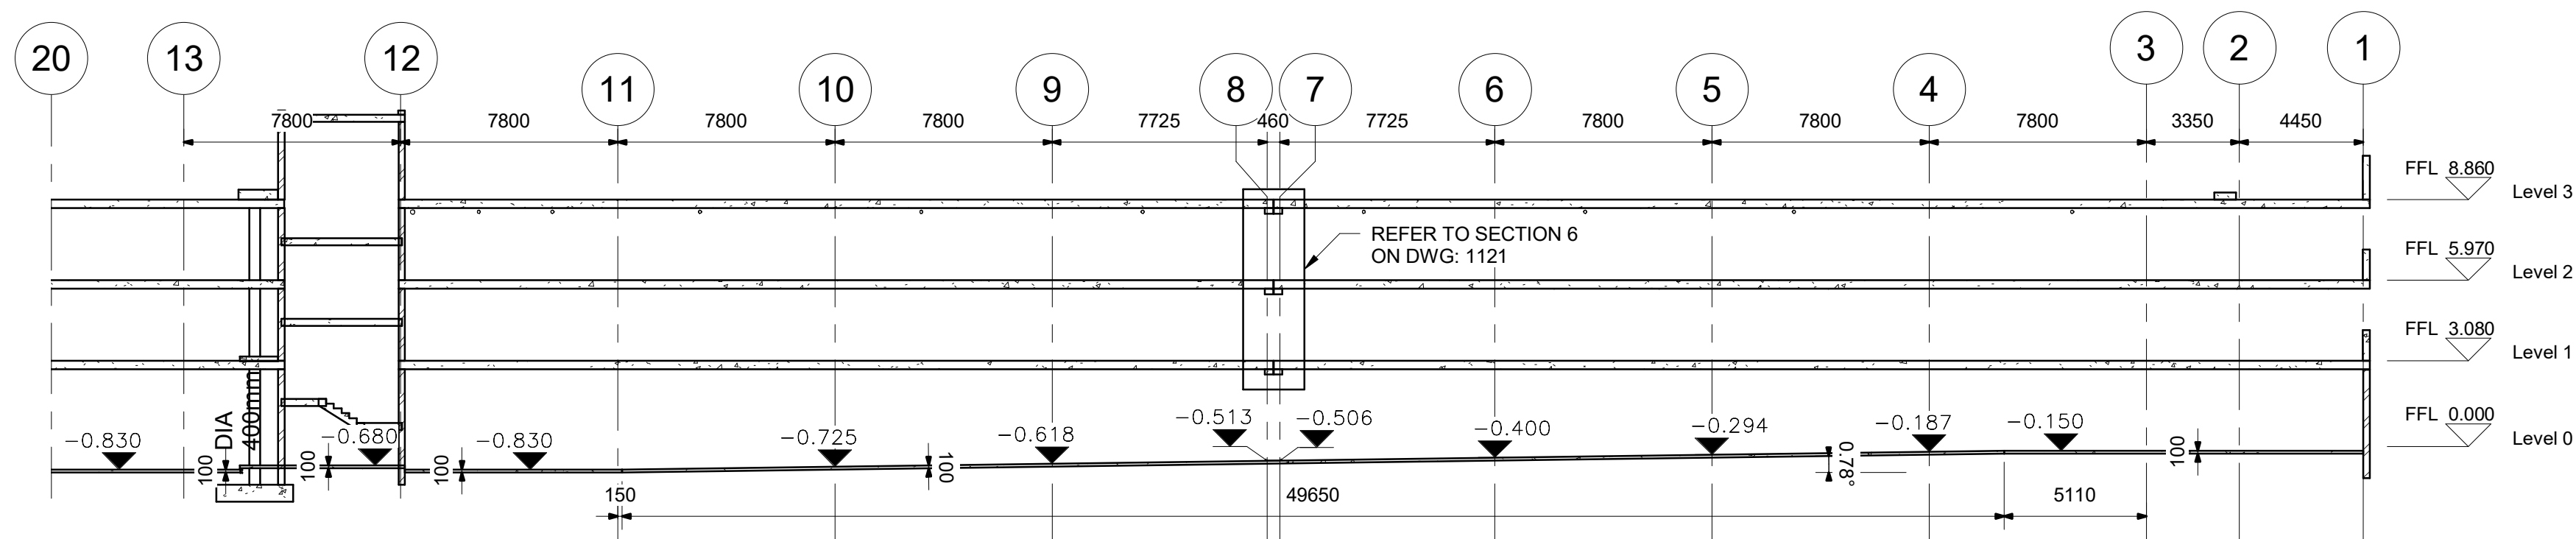

SECTION C

SCALE 1 : 200

SECTION NUMBER
01
SHEET NUMBER
100

LEVEL DATA : BUILDING

BUILDING LEVELS

BUILDINGS 6A, 6B 7 & 8 FINISHED FLOOR LEVEL (UFFL): 1670.880

NOTE:
- DRAWN BUILDING UFFL 0.000 = 1670.880
(UNFINISHED FLOOR LEVEL ON SECTIONS ARE DRAWN AS "0.000")
- ALL LEVEL VALUES ARE MEASURED RELATIVE TO THE UNFINISHED FLOOR LEVEL OF "0.000"

NOTE:
ALL NOTES REFER TO DWG NR 21377/000
UNLESS OTHERWISE STATED

* INDICATIVE T.O.C OF FOUNDATION T.B.C
PAD FOOTING TO BE FOUND
ON FERRICRETE SANDSTONE
(ALLOWABLE BEARING CAPACITY
BETWEEN 350 & 400 kPa) LOCATED
APROX 1.2m BELOW N.G.L

AS BUILT
DRAWING

No	DATE	DESCRIPTION
0	2022-05-25	ISSUED FOR CONSTRUCTION
1	2022-06-01	DETAILS UPDATED
2	2022-06-08	DETAILS ADDED
3	2022-07-06	DETAILS ADDED
4	2022-10-10	DETAILS UPDATED
5	2022-10-14	DETAILS ADDED
6	2022-10-27	DETAILS ADDED
7	2023-09-08	AS BUILT

REVISIONS

CLIENT
 GAUTENG PROVINCE ECONOMIC DEVELOPMENT REPUBLIC OF SOUTH AFRICA
Nyeleti Consulting (Pty) Ltd PO Box 35158 Menlo park 0102 Tel (012) 361 3629 Fax (012) 361 3525 E-mail info@nyeleti.co.za www.nyeleti.co.za
 Nyeleti Engineered to Excel

According to the Copyright Act (Act No 98 of 1978) No part of this document may be reproduced, stored in a retrieval system or transmitted in any form or by any means whatsoever including Mechanical, Electronic, Photocopying, Microfilming or any other system of information storage without the written permission of NYELETI CONSULTING (Pty) Ltd

DESIGNED BY

NAME	G Minnaar
Reg No.	

CHECKED BY

NAME	G Minnaar
Prof Reg No.	970287

DRAWN BY

NAME	PDP
PROJECT	JEWELRY MANUFACTURING PRECINCT

BUILDING 11
SECTION VIEWS 1

DRAWING DESCRIPTION

SCALE : AS SHOWN

DRAWING NUMBER	REVISION	SHEET SIZE
21905 - 1120	7	A1