



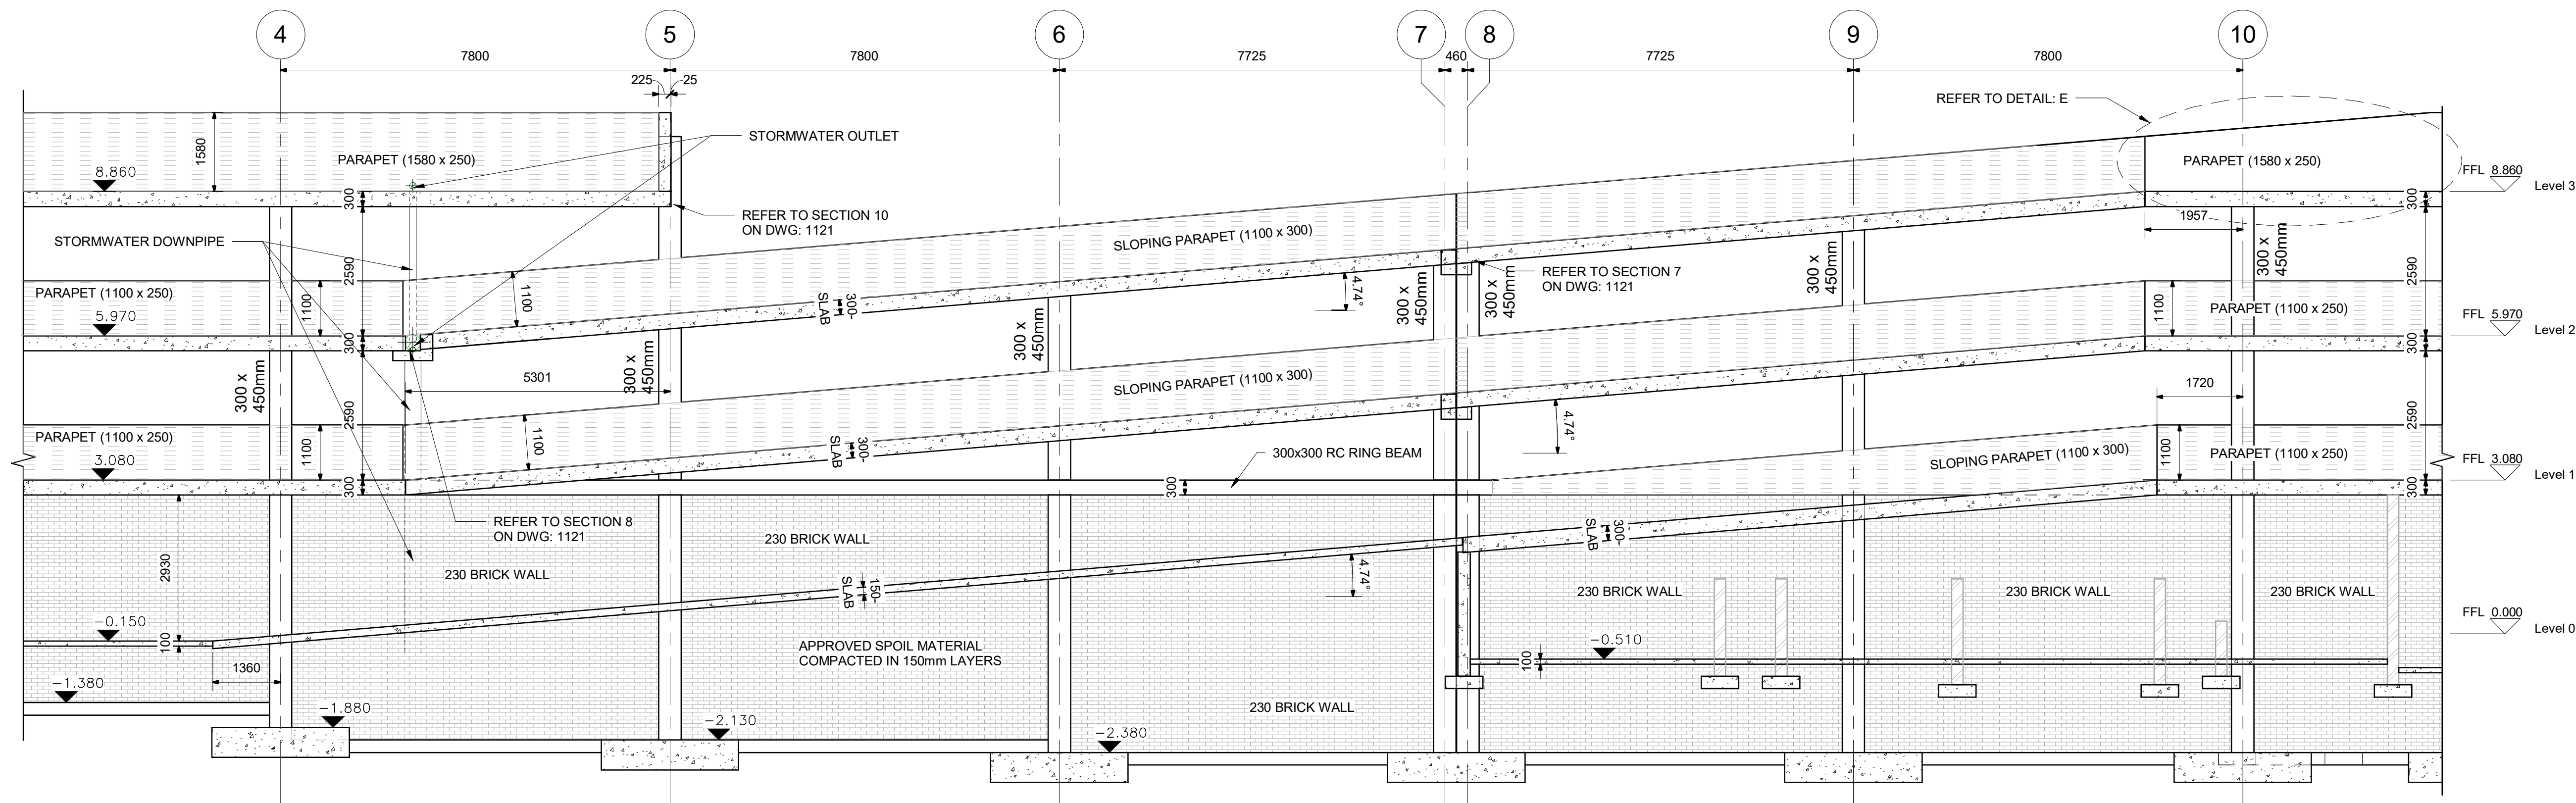

SECTION D GRIDLINE G OUTER (EASTWARDS FACING) WALL
SCALE 1 : 75

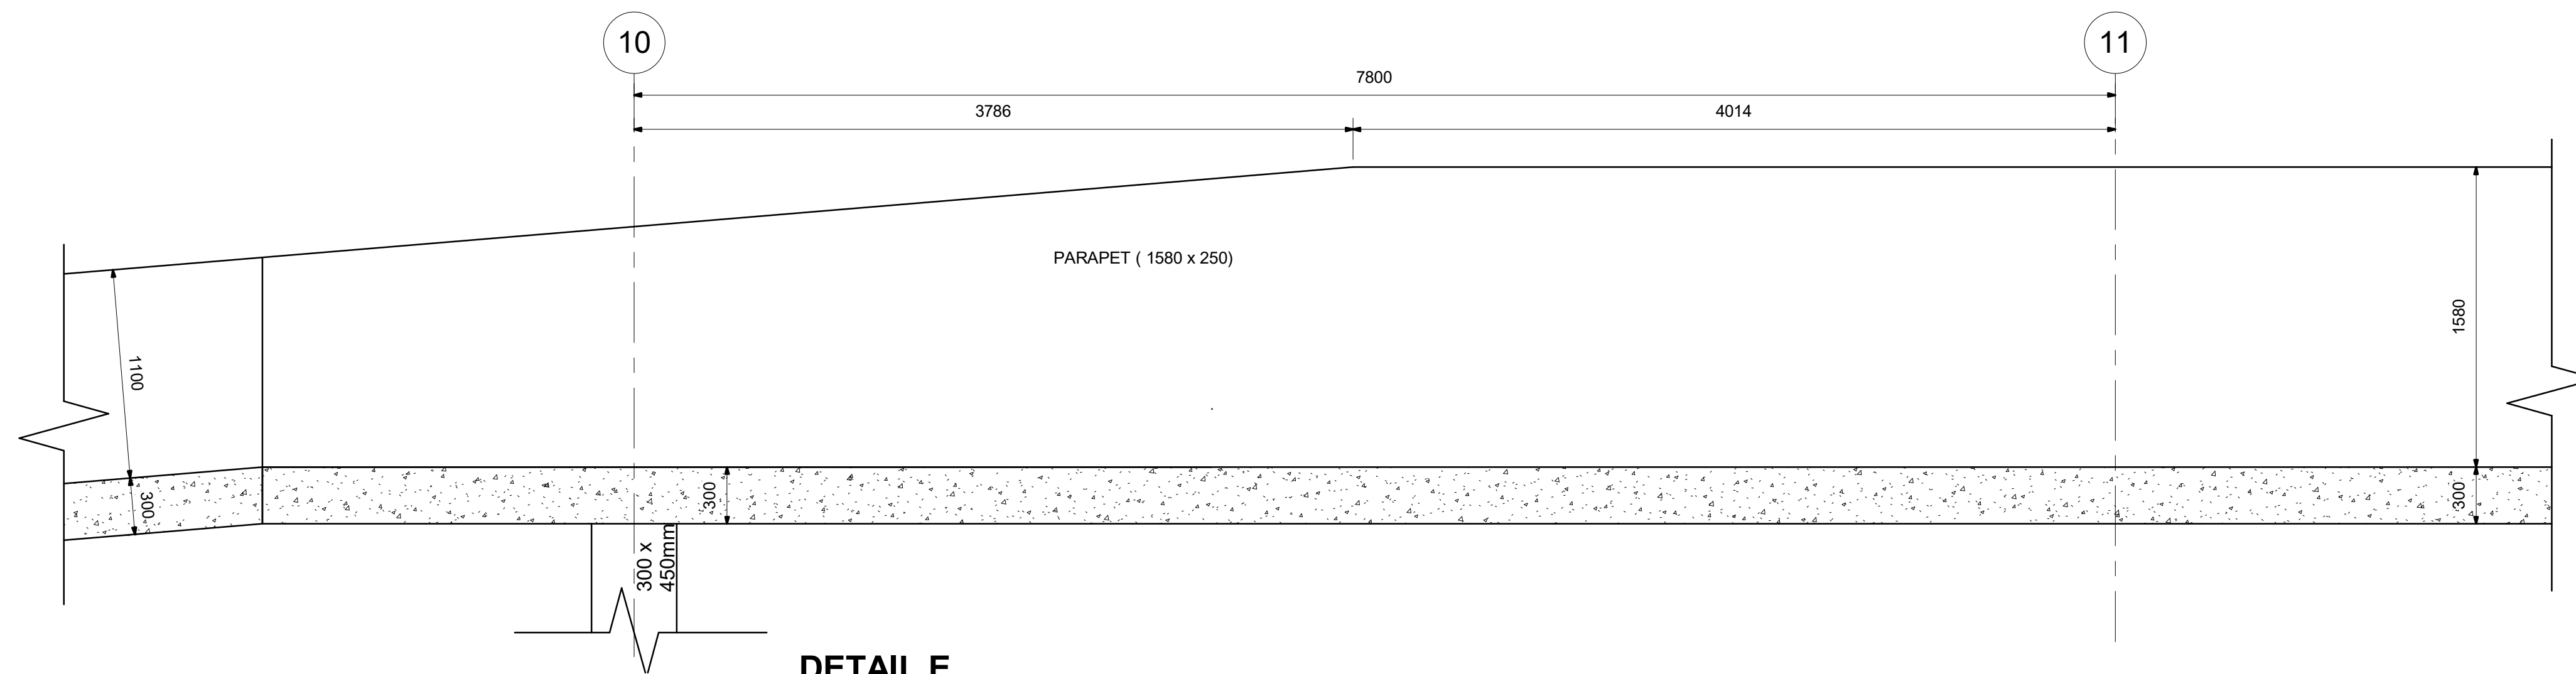

DETAIL E
SCALE 1 : 25

SW OUTLETS & DOWNPIPES POSITIONS &
DETAILS TO ARCHITECT . CIVIL ENG. DRAWINGS.

* INDICATIVE T.O.C OF FOUNDATION T.B.C
PAD FOOTING TO BE FOUNDED
ON FERRICRETE/ SANDSTONE
(ALLOWABLE BEARING CAPACITY
BETWEEN 350 & 400 kPa) LOCATED
APROX 1,2m BELOW N.G.L

LEVEL DATA : BUILDING

BUILDING LEVELS

BUILDINGS 6A, 6B 7 & 8 FINISHED FLOOR LEVEL (UFFL): 1670,880

NOTE:
- DRAWN BUILDING UFFL 0.000 = 1670,880
(UNFINISHED FLOOR LEVEL ON SECTIONS ARE
DRAWN AS "0.000")
- ALL LEVEL VALUES ARE MEASURED RELATIVE
TO THE UNFINISHED FLOOR LEVEL OF "0.000"

SETTING OUT OF WALLS TO BE BUILT ACCORDING TO ARCHITECTRAL DRAWINGS.
ANY DISCREPANCY TO BE BOUGHT TO ENGINEERS ATTENTION.

NOTE:
ALL NOTES REFER TO DWG NR 21377/000
UNLESS OTHERWISE STATED

AS BUILT
DRAWING

No	DATE	DESCRIPTION
0	2022-07-20	ISSUED FOR CONSTRUCTION
1	2022-10-10	DETAILS UPDATED
2	2022-10-14	DETAILS ADDED
3	2022-10-27	DETAILS ADDED
4	2023-02-22	DRAWING UPDATED
5	2023-09-08	AS BUILT

REVISIONS

CLIENT
 GAUTENG PROVINCE ECONOMIC DEVELOPMENT REPUBLIC OF SOUTH AFRICA
Nyeleti Consulting (Pty) Ltd PO Box 35158 Menlo park 0102 Tel (012) 361 3629 Fax (012) 361 3525 E-mail info@nyeleti.co.za www.nyeleti.co.za
 Nyeleti Engineered to Excel

According to the Copyright Act (Act No 98 of 1978) No part of this document may be reproduced, stored in a retrieval system or transmitted in any form or by any means whatsoever including Mechanical, Electronic, Photocopying, Microfilming or any other system of information storage without the written permission of NYELETI CONSULTING (Pty) Ltd

DESIGNED BY

NAME	G Minnaar
Reg No.	

CHECKED BY

NAME	G Minnaar
Prof Reg No.	970287

NAME	PDP
PROJECT	

JEWELRY
MANUFACTURING
PRECINCT

BUILDING 11
SECTION VIEWS 3

SCALE : AS SHOWN	REVISION	SHEET SIZE
DRAWING NUMBER	21905 - 1122	5 A1