



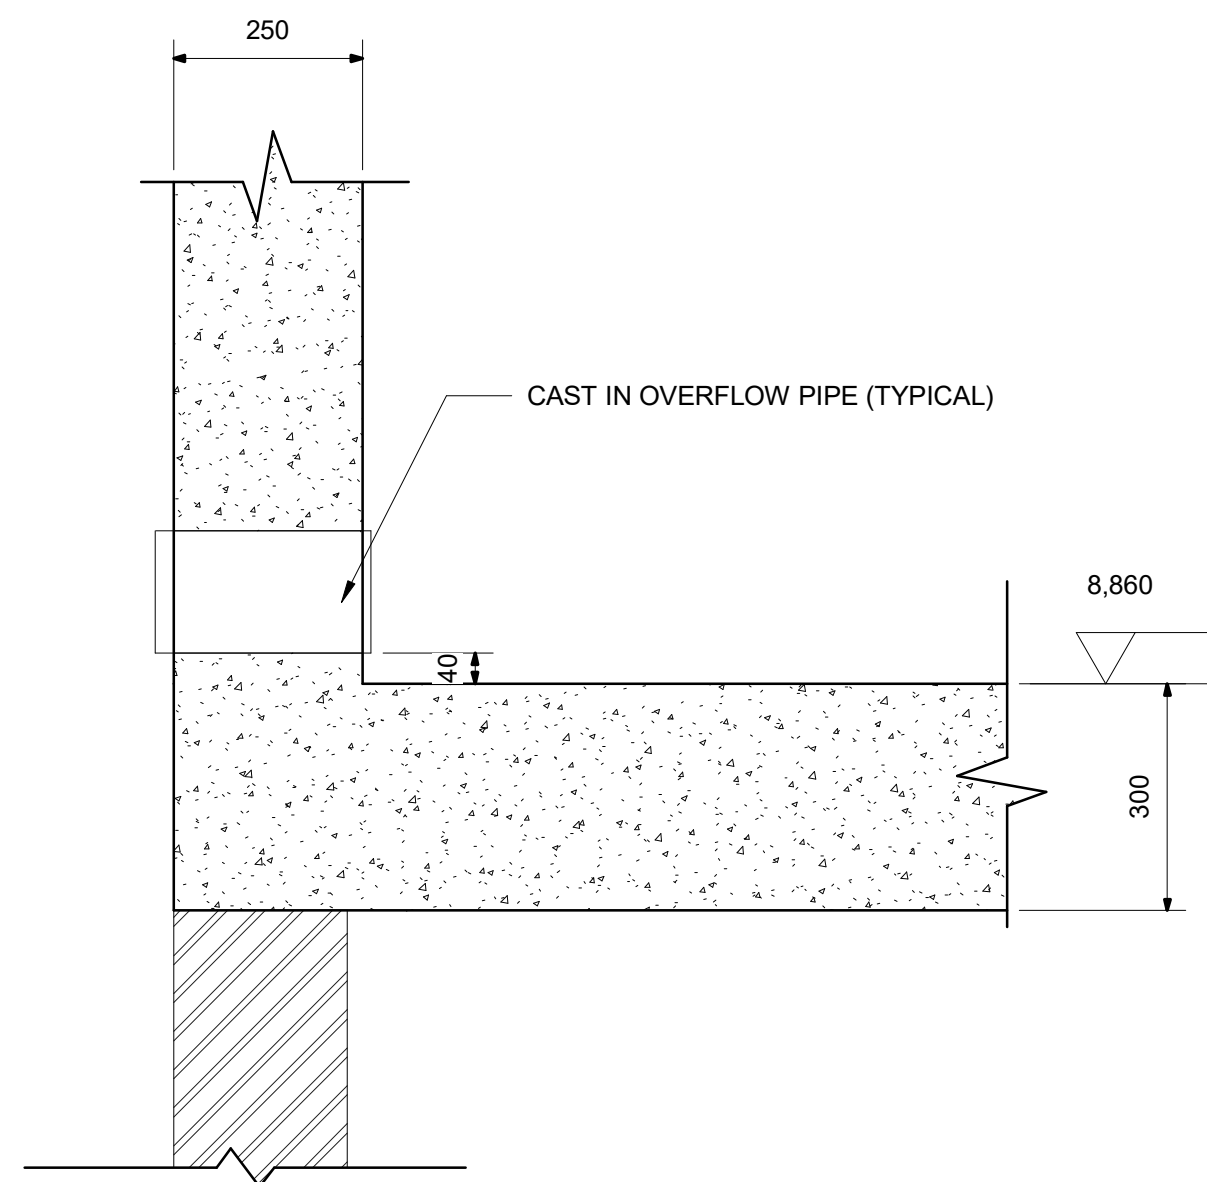

TYPICAL STORMWATER OVERFLOW OUTLET ALONG ROOF SLAB PERIMETER

SCALE 1 : 10

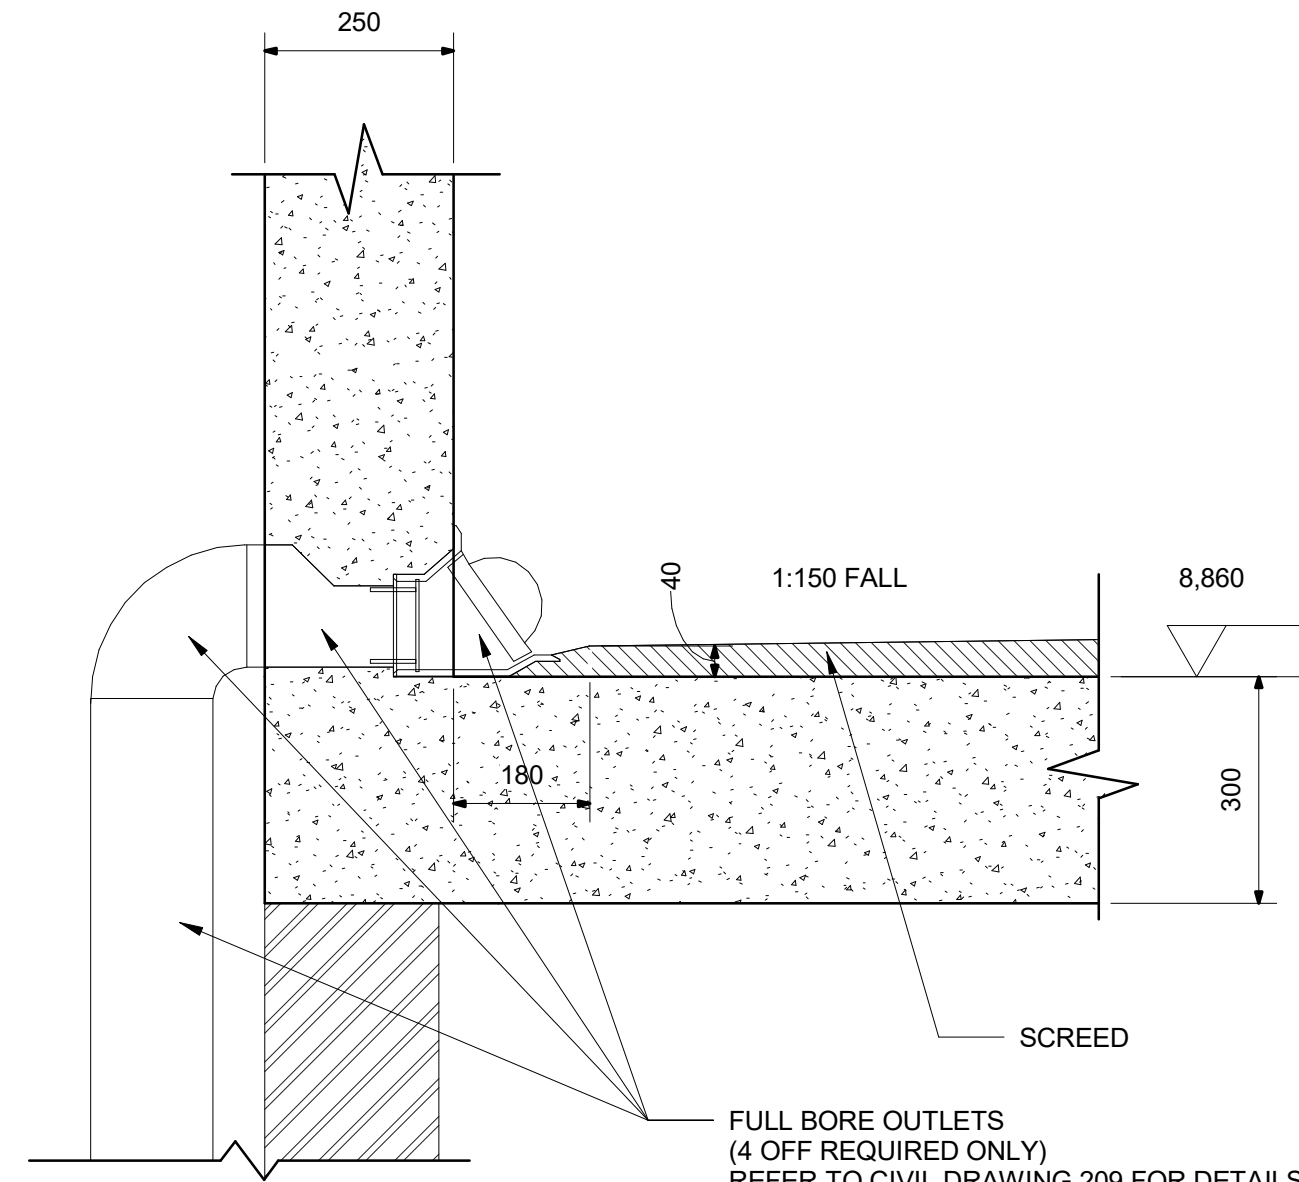

TYPICAL STORMWATER FULL BORE OUTLET ALONG ROOF SLAB PERIMETER

SCALE 1 : 10

SECTION NUMBER
01
SHEET NUMBER
100

**AS BUILT
DRAWING**

No	DATE	DESCRIPTION
0	2022-10-13	ISSUED FOR CONSTRUCTION
1	2022-10-27	DETAILS ADDED
2	2023-02-22	DRAWING UPDATED
3	2023-09-08	AS BUILT

REVISIONS



Nyeleti Consulting (Pty) Ltd
PO Box 35158 Menlo park 0102
Tel (012) 361 3629
Fax (012) 361 3525
E-mail info@nyeleti.co.za
www.nyeleti.co.za



According to the Copyright Act (Act No 98 of 1978) No part of this document may be reproduced, stored in a retrieval system or transmitted in any form or by any means whatsoever including Mechanical, Electronic, Photocopying, Microfilming or any other system of information storage without the written permission of NYELETI CONSULTING (Pty) Ltd

DESIGNED BY

NAME	G Minnaar
Reg No.	

CHECKED BY

NAME	G Minnaar
Prof Reg No.	970287

DRAWN BY

NAME	PDP
------	-----

**JEWELRY
MANUFACTURING
PRECINCT**

**BUILDING 11
DETAILS 1**

SCALE : AS SHOWN	REVISION	SHEET SIZE
DRAWING NUMBER	21905 - 1133	3 A1

NOTE:
ALL NOTES REFER TO DWG NR 21377/000
UNLESS OTHERWISE STATED

