




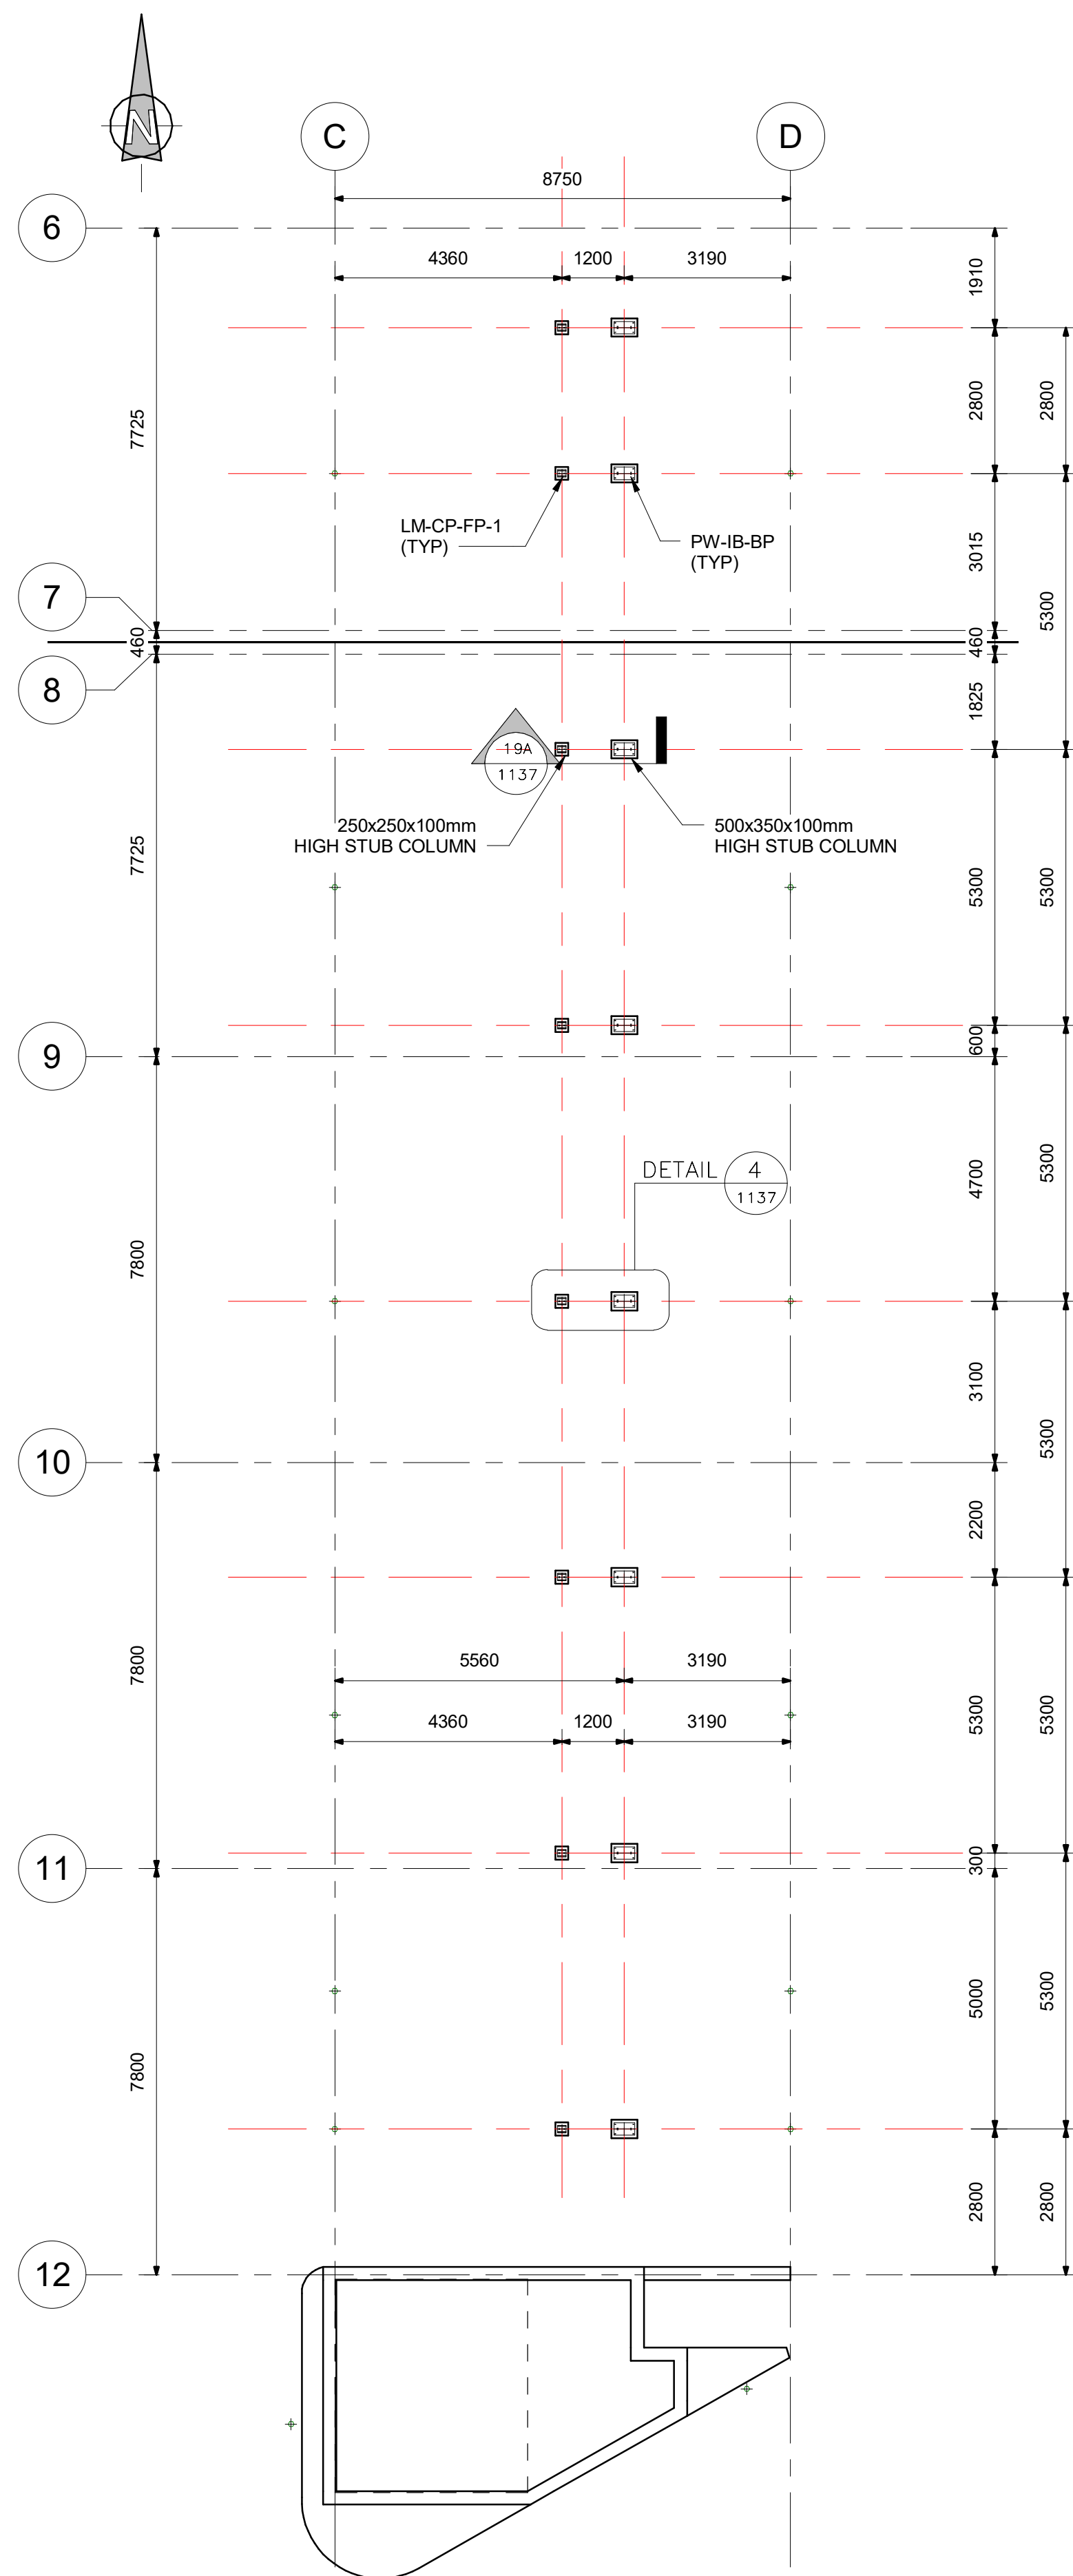


SUN PANELS PLAN LAYOUT
SCALE 1 : 150

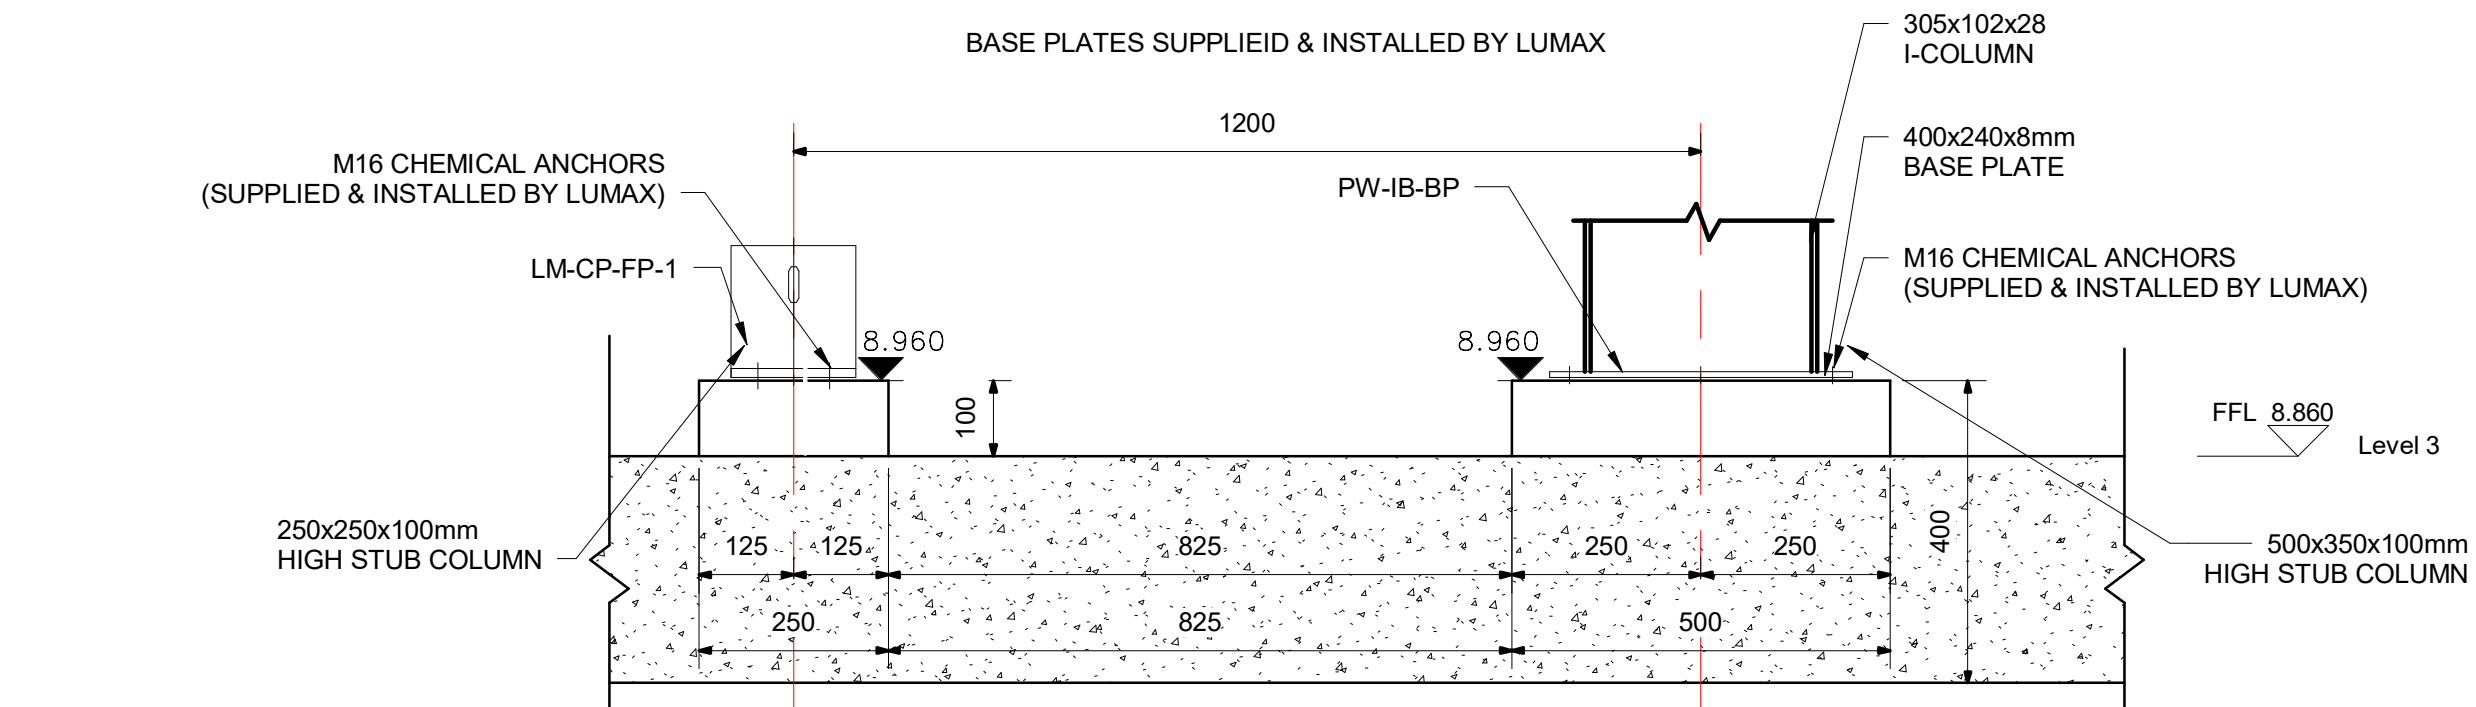


SECTION 19A (8 OFF)
SCALE 1 : 10

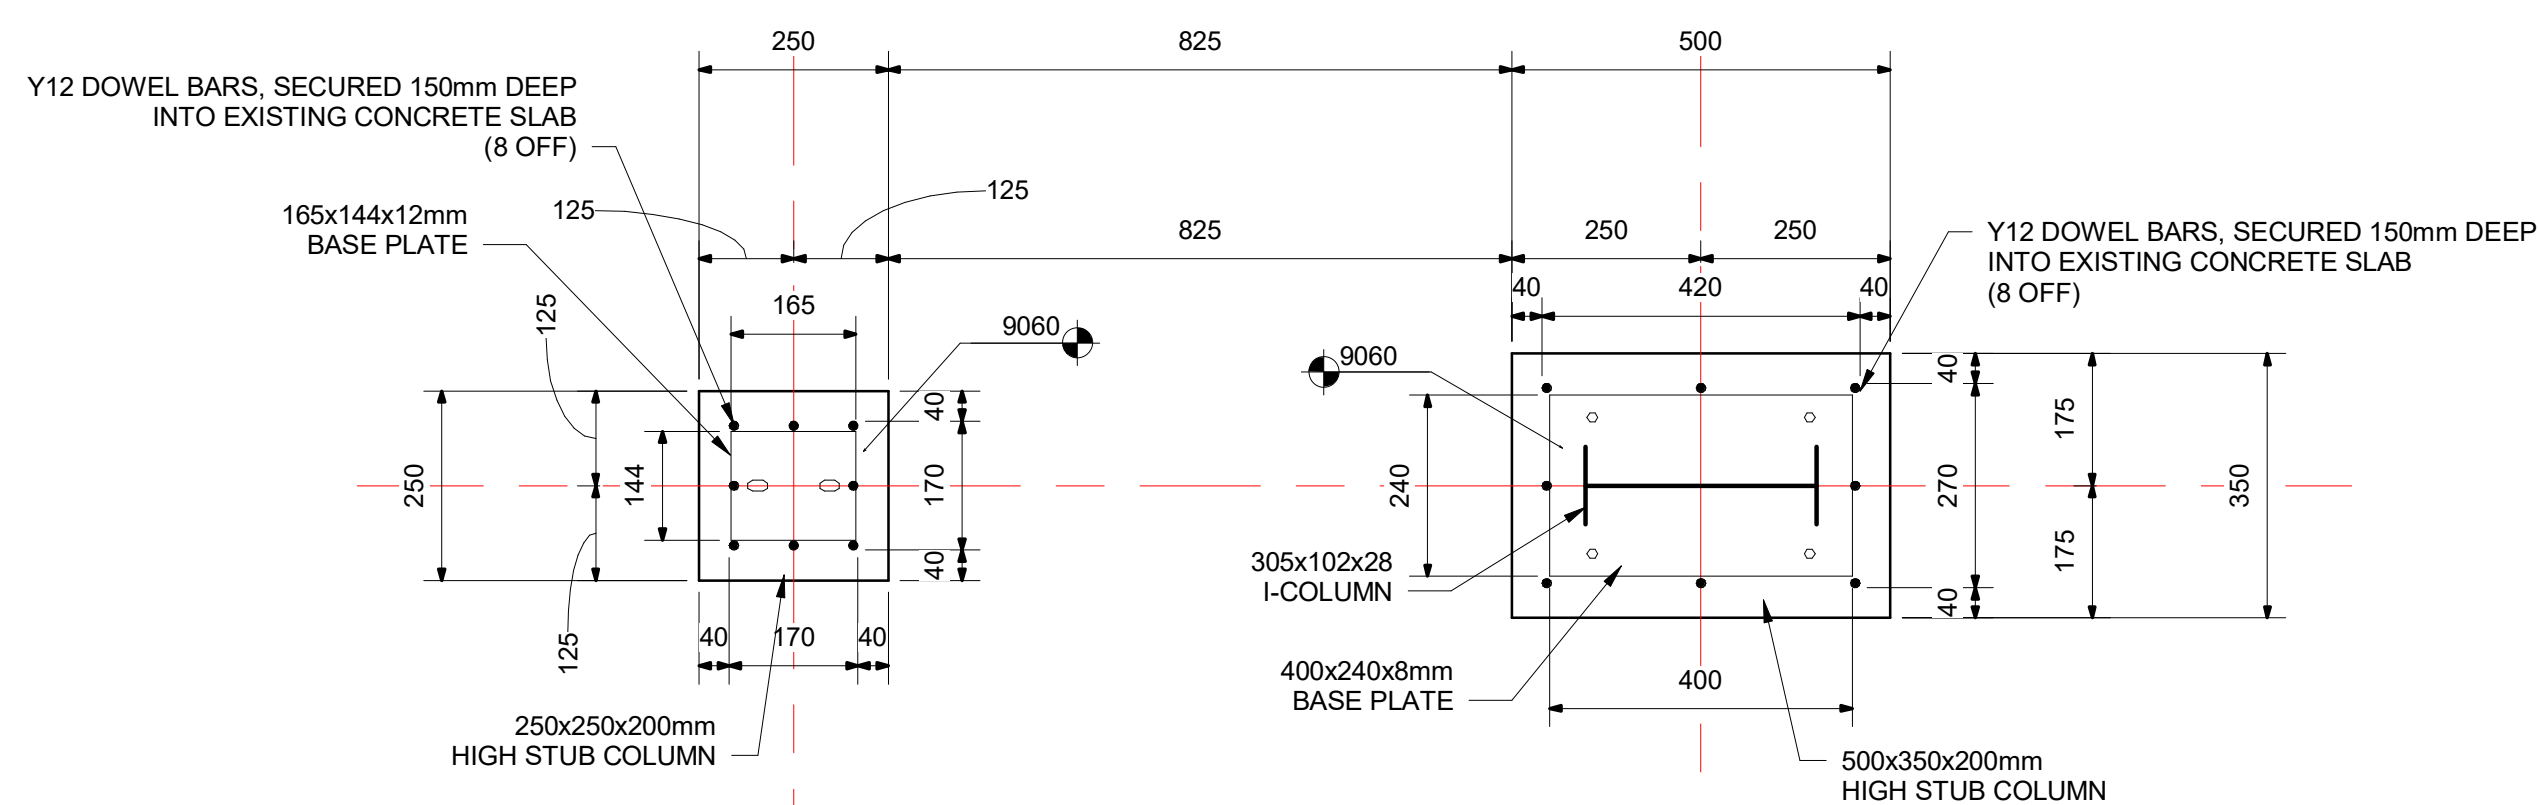


DETAIL 4 (8 OFF)
SCALE 1 : 10

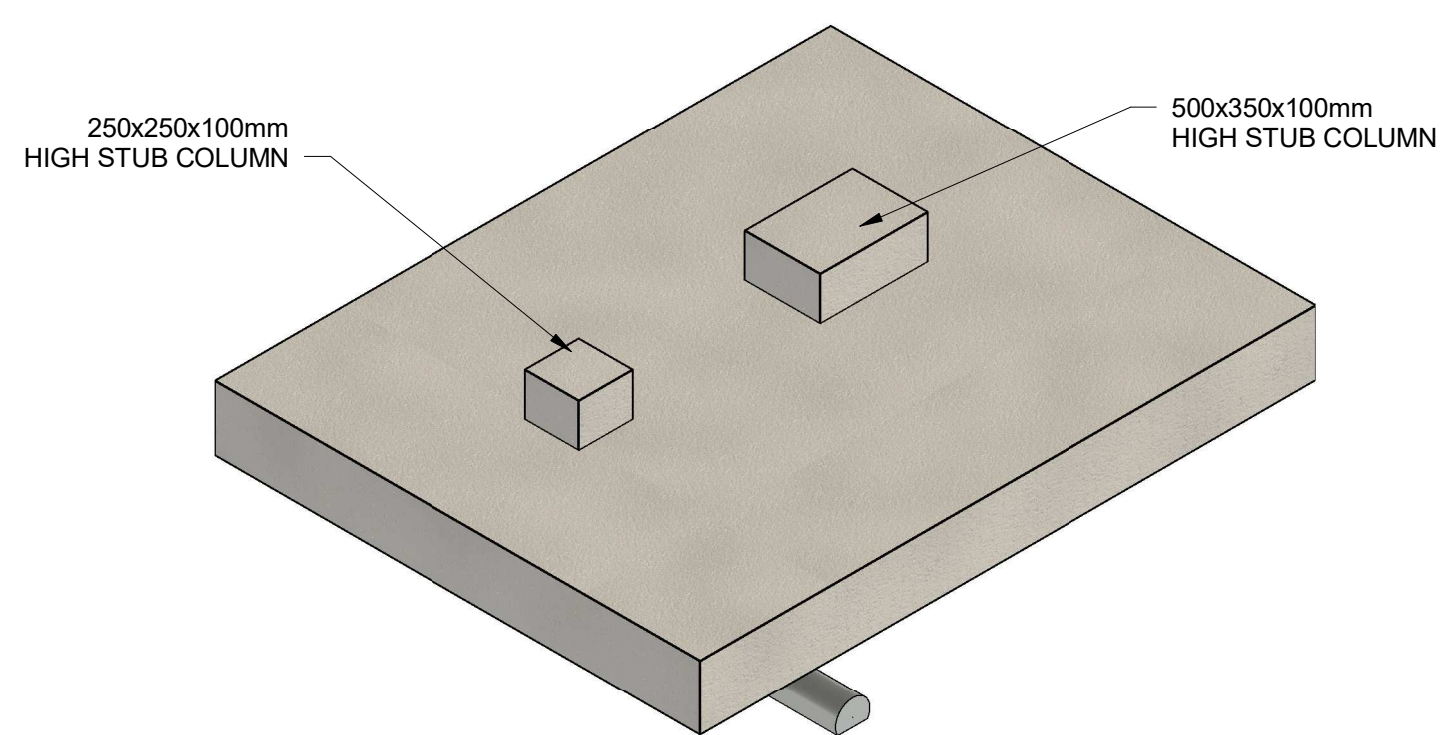

3D VIEW PLINTHS

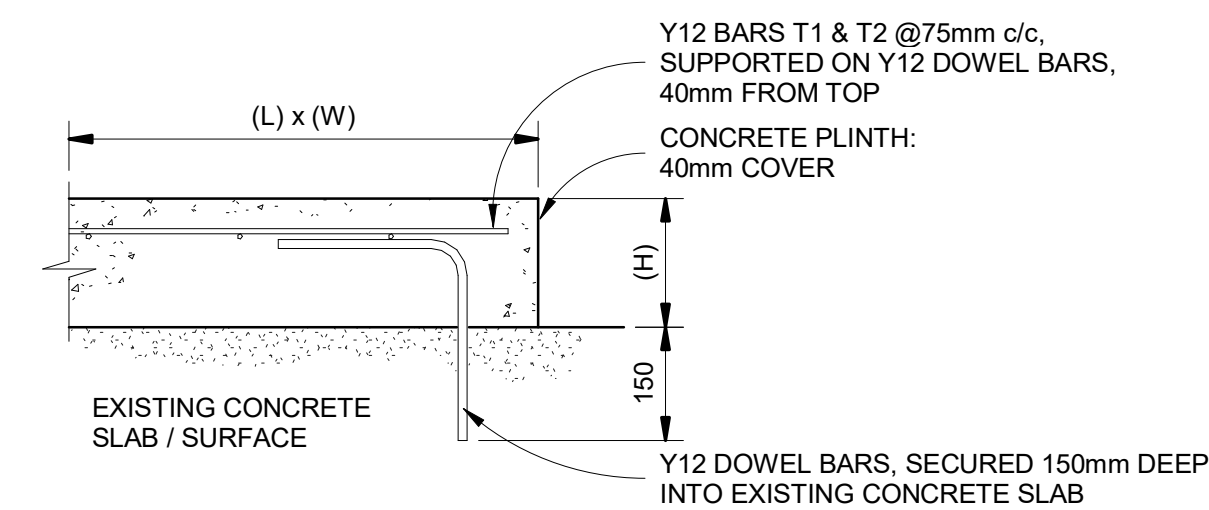

ROOF PLINTH SECTION 1
SCALE 1 : 10

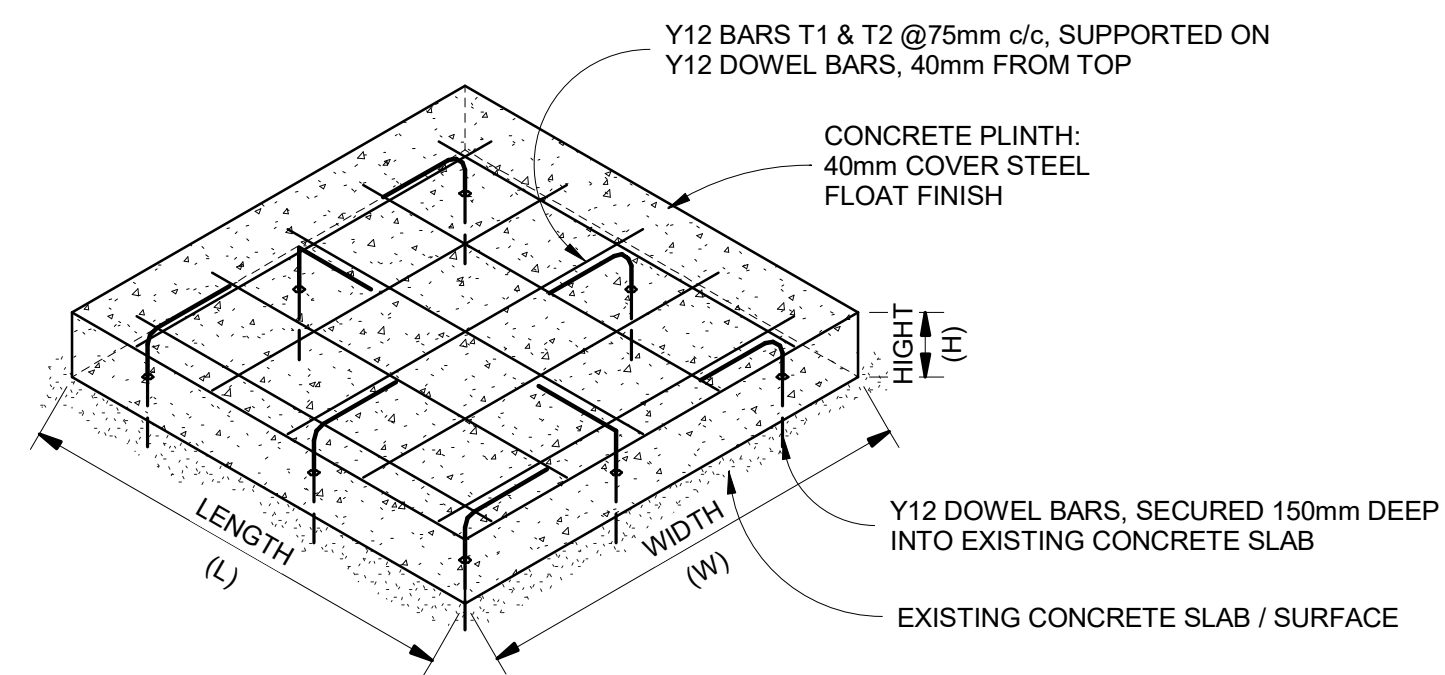

ROOF PLINTH (ISOMETRIC VIEW1)
SCALE 1 : 20

NOTE:
ALL NOTES REFER TO DWG NR 21377/000
UNLESS OTHERWISE STATED

LEVEL DATA : BUILDING
BUILDING LEVELS
BUILDINGS 6A, 6B 7 & 8 FINISHED FLOOR LEVEL (UFFL): 1670,880
NOTE: - DRAWN BUILDING UFFL 0.000 = 1670,880 (UNFINISHED FLOOR LEVEL ON SECTIONS ARE DRAWN AS "0.000") - ALL LEVEL VALUES ARE MEASURED RELATIVE TO THE UNFINISHED FLOOR LEVEL OF "0.000"

SECTION NUMBER
SECTION NUMBER
SHEET NUMBER

**AS BUILT
DRAWING**

No	DATE	DESCRIPTION
0	2023-02-10	ISSUED FOR CONSTRUCTION
1	2023-09-08	AS BUILT

REVISIONS

CLIENT
 GAUTENG PROVINCE ECONOMIC DEVELOPMENT REPUBLIC OF SOUTH AFRICA

Nyeleti Consulting (Pty) Ltd PO Box 35158 Menlo park 0102 Tel (012) 361 3629 Fax (012) 361 3525 E-mail info@nyeleti.co.za www.nyeleti.co.za	 Nyeleti Engineered to Excel
--	---

According to the Copyright Act (Act No 98 of 1978) No part of this document may be reproduced, stored in a retrieval system or transmitted in any form or by any means whatsoever including Mechanical, Electronic, Photocopying, Microfilming or any other system of information storage without the written permission of NYELETI CONSULTING (Pty) Ltd

DESIGNED BY
NAME: G Minnaar
Reg No.
CHECKED BY
NAME: G Minnaar
Prof Reg No. 970287
DRAWN BY PDP
PROJECT
JEWELRY MANUFACTURING PRECINCT

DRAWING DESCRIPTION
BUILDING 11 SUN PANEL SUPPORT STRUCTURE AT ROOF LEVEL

SCALE : AS SHOWN		
DRAWING NUMBER	REVISION	SHEET SIZE
21905 - 1137	1	A1